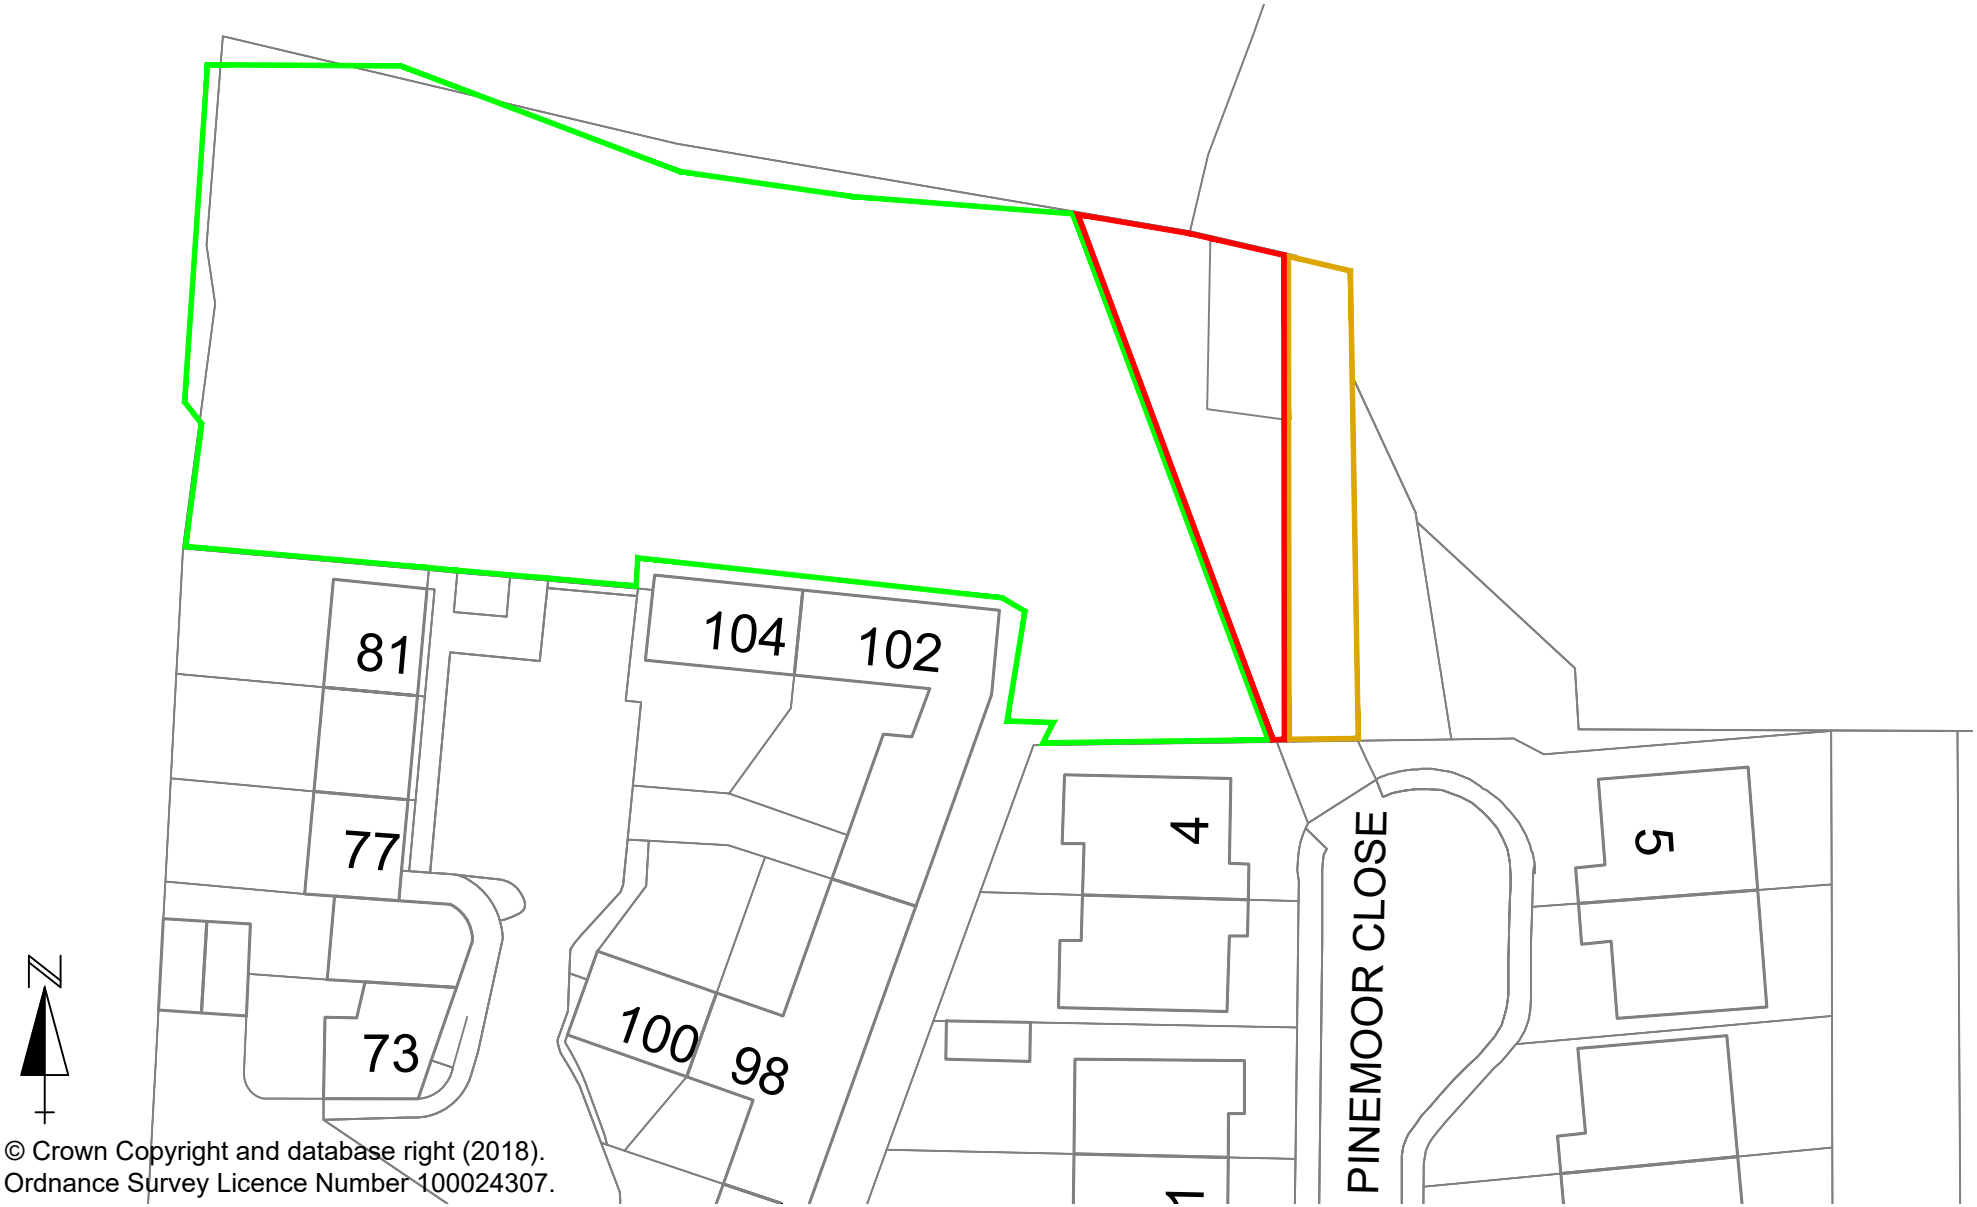

© Crown Copyright and database right (2018).
Ordnance Survey Licence Number 100024307.

Weymouth & Portland
Borough Council

South Walks House,
South Walks Road,
DORCHESTER,
Dorset.
DT1 1UZ
Tel: 01305 251010 Fax: 01305 251481

Southdown Farm
Correcting transfer land - red
As-built access - brown
Land Registry - green

Date : 22-10-18

Scale 1 : 500 @ A4